BRUHAT BANGALORE MAHANAGARA PALIKE

Improvements to widen portion of roads,construction of New drains,UG cable duct and Footpath at Doddabommasandra main road surrounding road in Ward No.10

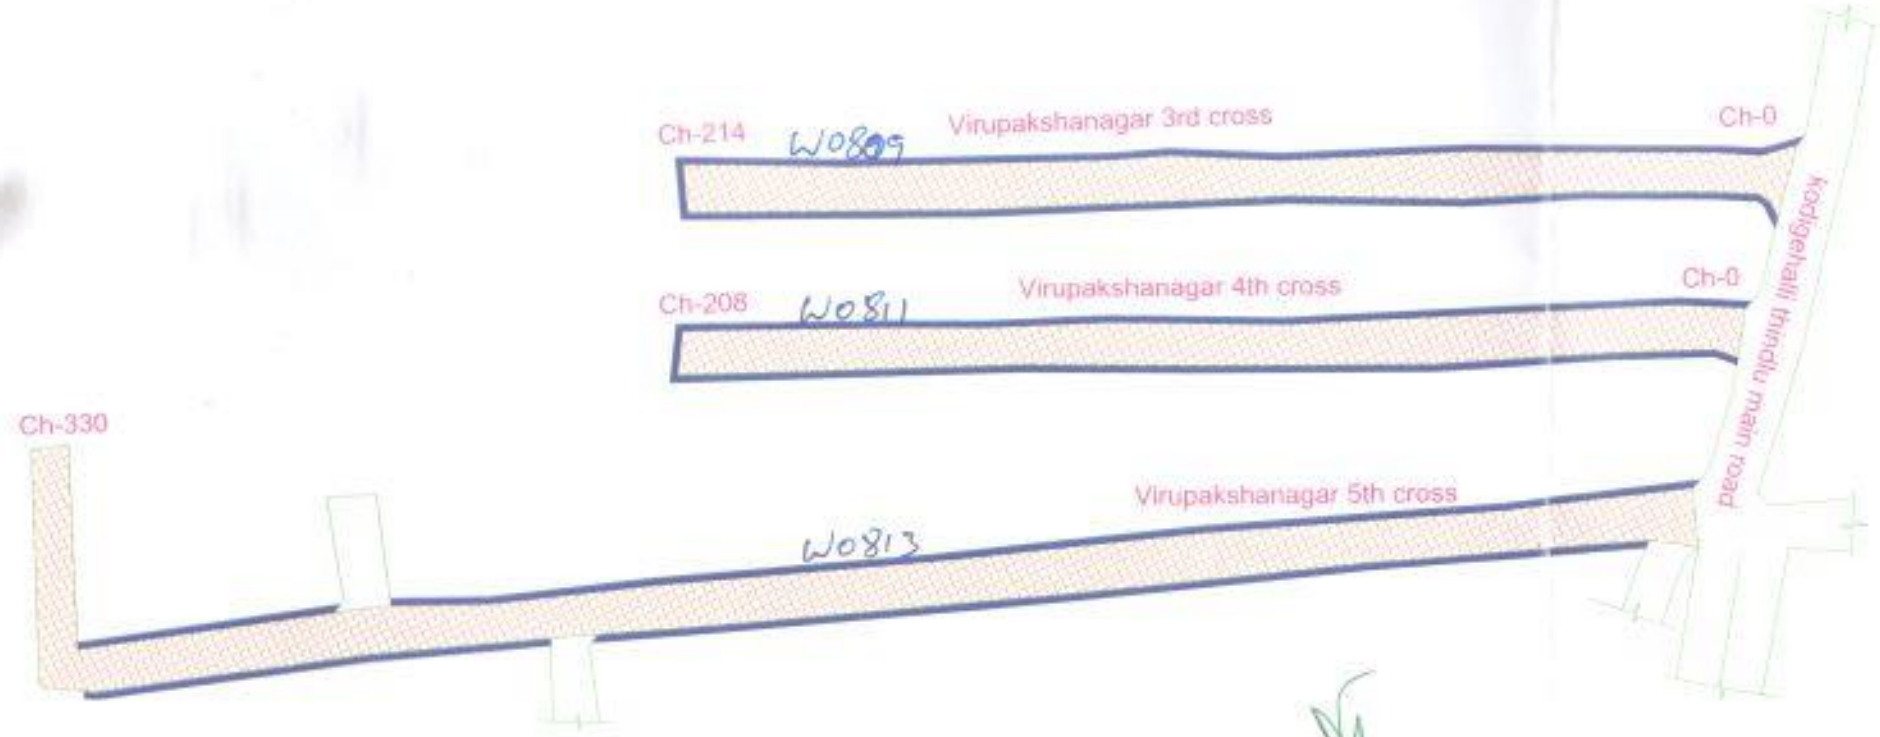

AE

Asst. Executive Engineer
Project Division
Yelahanka Zone
BBMP, Bangalore - 92

Existing Asphalt Road

Existing Drain

CONSULTANT
TEJUS CONSULTANTS

TITLE
As Built Drawing

BRUHAT BANGALORE MAHANAGARA PALIKE

Improvements to widen portion of roads,construction of New drains,UG cable duct and Footpath at Doddabommasandra main road surrounding road in Ward No.10

AE

Asst. Executive Engineer
Project Division
Yelahanka Zone
BBMP, Bangalore - 92

1. ALL DIMENSION & LEVELS ARE MM. UNLESS OTHERWISE MENTIONED.

Asphalt Overlay

Existing Drain

TEJUS CONSULTANTS

TITLE: As Built Drawing

BRUHAT BANGALORE MAHANAGARA PALIKE

Improvements to widen portion of roads,construction of New drains,UG cable duct and Footpath at Doddabommasandra main road surrounding road in Ward No.10

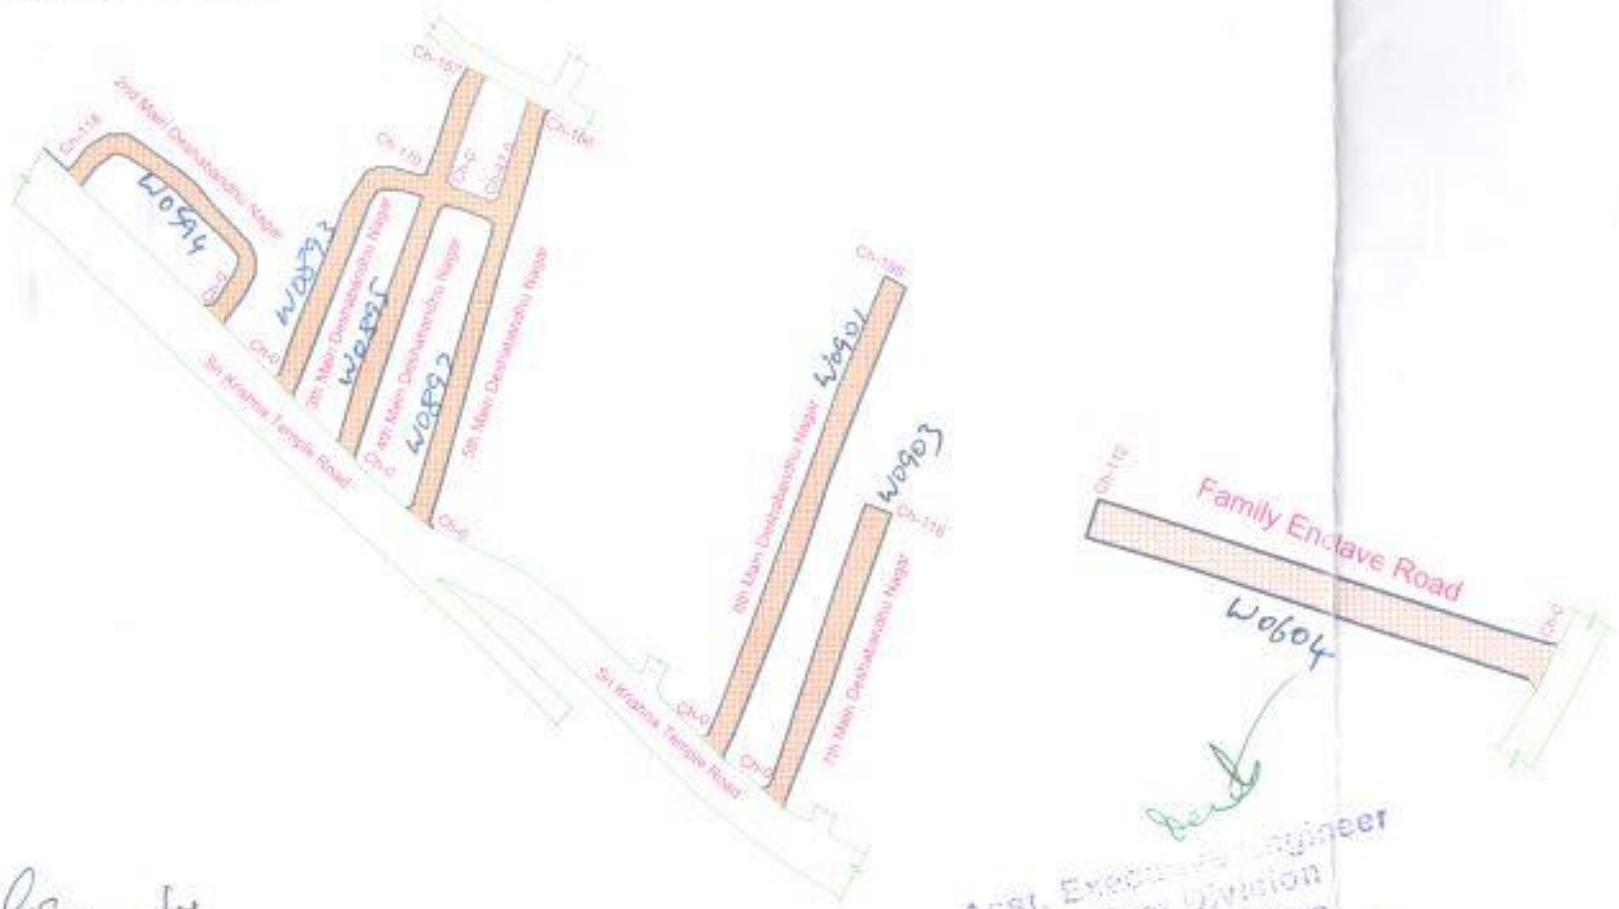

AE

Asst. Executive Engineer
Project Division
Yelahanka Zone
BBMP, Bangalore - 92

NOTE:-
1. ALL DIMENSION & LEVELS ARE Mts. UNLESS OTHERWISE MENTIONED.

Asphalt Overlay

Existing Drain

CONSULTANT :
TEJUS CONSULTANTS

TITLE :
As Built Drawing